


21 1942

Webster Ave. No. 92

Name of Owner  
Stone Contractor

Labor and Mat'l. Report May 18 1942

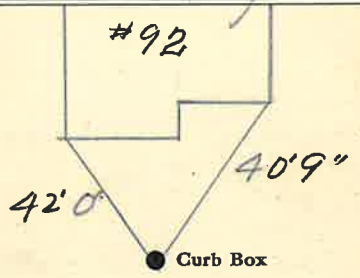

12 Main Elev. of Main at tap 5

Gate at ● Gate at ●  
16' to MAIN


● Curb Box

H.

St.  
Pl.  
Ave. No.

Name of Owner  
94 WEBSTER

Labor and Mat'l. Report 19

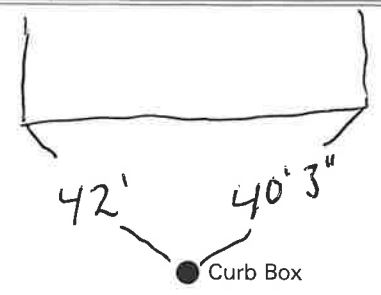

12' Main Elev. of Main at tap

Gate at ● Gate at ●

TAX ID# 302.12-2-21

● Curb Box

