


LABOR AND MATERIALS

Copper	} Connection	_____	\$	_____	
Lead					
Curb	} Cock Valve T. S. & V.	_____ in.	\$	_____	
Service box		} Short 3 1/2 x 4 1/2 Long 4 1/2 x 5 1/2			
Old returned			} Buff or Rdway	_____	\$
Ft. _____ in.	} Copper G. I. C. I.	Pipe at _____	\$	_____	
Nipples _____ in.		at _____	\$	_____	
Bushings _____ to _____ in.		at _____	\$	_____	
Red'g } Inc'g }	} Coupl'gs	_____ to _____ in.	at _____	\$	
Union _____ in.		at _____	\$	_____	
Meter _____ in.	at _____	\$	_____		
Lead Joints	at _____	\$	_____		
Compound Joints	at _____	\$	_____		
Maintenance Foreman	at _____	\$	_____		
Hrs. Water Maint. Man—1	at _____	\$	_____		
Hrs. Water Maint. Man—2	at _____	\$	_____		
Hrs. Garage Foreman	at _____	\$	_____		
Hrs. Labor—	at _____	\$	_____		
Hrs. Compressor	at _____	\$	_____		
Compensation Ins. at \$ _____	per C.	\$	_____		
Trucking	_____	\$	_____		
Pav't Patch	_____	\$	_____		
_____		\$	_____		
_____		\$	_____		
_____		\$	_____		
_____		\$	_____		
O'head	_____	\$	_____		
		\$	_____		

St. \_\_\_\_\_  
Fl. \_\_\_\_\_  
Ave. No. 14

Name of Owner  
Webster  
Alec Sherman

Labor and Mat'l. Report 19

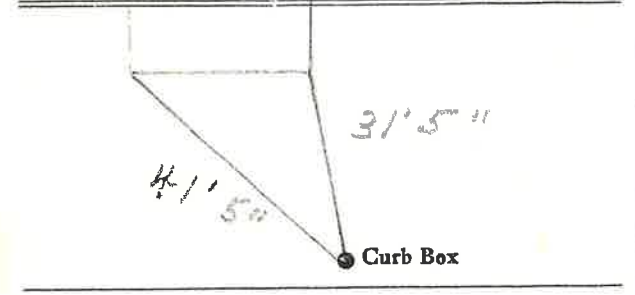

12" Main Elev. of  
Main at tap 4 1/2'

Gate at • • Gate at

TAX ID # 302.11-3-23

• Curb Box