

WATER DEPARTMENT

City of Glens Falls, New York

8 - 7 - 1951

_____ A. M. _____ P. M.

M. Renewal $3/4$ " Tap

Tel. Call: Sewer Pumping

Turn on: Station

Shut off: Webster Ave.

Leak: _____

Misc: _____

REMARKS: 2- $3/4$ " Male
Adapters - 1- $1/4$ " x $3/4$ "
Reducing Coupling
1'- $3/4$ " K. Copper
Repaired by Miller
& Co. 8-7-51

By: *Reynolds* From: *Tripp* To: _____


Form Mem. 2006-12-15-49

Used old tap $1/4$ " corr. stop

Labor and Material Report

Oct 5 7 1929

Pumping Sta Sewer Webster Ave

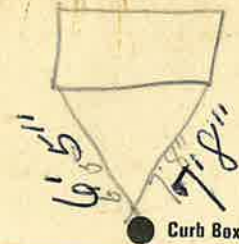

Main _____ Eley of Main at tap _____
Gate at ● _____ Gate at ● _____

● Curb Box

#85-93
Pump Station

Tax ID

302.12-17-4

[Faint, mostly illegible handwritten notes and printed text on a ledger page, possibly including a date and company name.]

Labor and Materials

Copper } Connection.....	\$.....
Lead }.....	\$.....
/ Curb { Cook Valve } 1 1/2 in.....	\$.....
	T. S. & V.
/ Service Box { Short 3 1/2 x 4 1/2 }.....	\$.....
- Old returned { Long 4 1/2 x 5 1/2 }.....	\$.....
	Buff. or Rdway }
Ft. in. } Copper } Pipe at.....	\$.....
	Galv. Iron }
/ Nipples. " } in. at.....	\$.....
	Cast Iron }
Bushings..... to..... in. at.....	\$.....
Red'g } Couplings..... to..... in. at.....	\$.....
Inc'g }	
Union..... in. at.....	\$.....
Meter..... in. at.....	\$.....
Lbs. Br. Stone at.....	\$.....
Lbs. Sand at.....	\$.....
Bags Cement at.....	\$.....
Paving Brick { Mack Red Asphalt } at.....	\$.....
Lead Joints at.....	\$.....
Leadite Joints at.....	\$.....
Hrs. Foreman at.....	\$.....
Hrs. Common Labor at.....	\$.....
Hrs. Common Labor at.....	\$.....
Hrs. Mason at.....	\$.....
Hrs. Mason's Helper at.....	\$.....
Hrs. Compressor at.....	\$.....
Compensation Ins.....	\$.....
Trucking.....	\$.....
Builders' Use of Water.....	\$.....
Total \$.....	

4 1941


Webster

St. Ave. No. 89

Name of Owner

Anthony Jones
Geo Elisse

Labor and Mat'l. Report Jan 10 1941

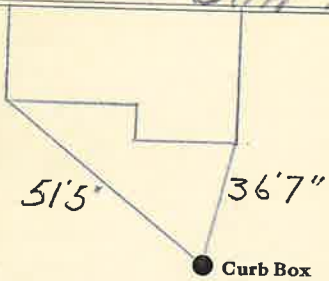

12 Main

Elev. of Main at tap 5-

Gate at ●

● Gate at

12' to main

● Curb Box

70
New House

6 - - 1939


Webster Ave

St. Pl. Ave. No.

Name of Owner

Anthony Jones

Labor and Mat'l. Report Nov 27 1939

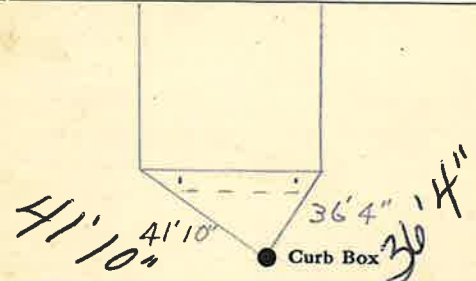

12 Main

Elev. of Main at tap 3

Gate at ●

● Gate at

10' to main

● Curb Box

New Tap

DB

