

Labor and Material Report

3 1930

.19 Webster Ave



● Curb Box

12 Main

Elev of Main at tap 4

Gate at ●

● Gate at

● Curb Box

Earl  
Monroe

Webster


St. 19  
Pl. Ave. No.

Name of Owner

Richard Lee

Labor and Mat'l. Report

19

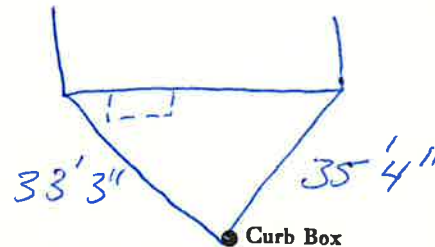

● Curb Box

Main

Elev. of Main at tap

Gate at ●

● Gate at

3/4" Copper

34' to MAIN

● Curb Box

Ties taken 1988

TAX ID# 302.11-6-15

