

LABOR AND MATERIALS


3/4" <u>Copper</u> Lead	Connection	_____	\$ _____
Curb	Cock Valve T.S. & V. } _____ in.	_____	\$ _____
		_____	\$ _____
Service box	Short 3 1/2 x 4 1/2 } Long 4 1/2 x 5 1/2 }	_____	\$ _____
Old returned		_____	\$ _____
8 Ft. 0 in.	<u>Copper</u> G.I. C.I. Pipe	at _____	\$ _____
Nipples	_____ in. at _____		\$ _____
Bushings	_____ to _____ in. at _____		\$ _____
Red'g } Inc'g }	Coupl'gs _____ to _____ in. at _____		\$ _____
Union	_____ in. at _____		\$ _____
Meter	_____ in. at _____		\$ _____
Compound Joints	at _____		\$ _____
Maintenance Foreman			\$ _____
Hrs. Water Maint. Man-1	at _____		\$ _____
Hrs. Water Maint. Man-2	at _____		\$ _____
Hrs. Garage Foreman	at _____		\$ _____
Hrs. Labor	at _____		\$ _____
Hrs. Compressor	at _____		\$ _____
Trucking			\$ _____
Pav't Patch			\$ _____
			\$ _____
			\$ _____
			\$ _____
			\$ _____

Corner of Luxeme & Western

St. \_\_\_\_\_  
Pl. \_\_\_\_\_  
Ave. No. \_\_\_\_\_

Name of Owner  
Daggett's Kennedy

Labor and Mat'l. Report 19

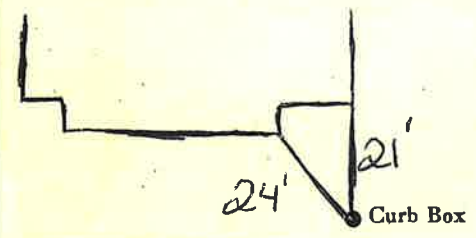

12 Main Elev. of Main at tap 5'

Gate at • • Gate at

8' to main

• Curb Box

Used to Master's Place