

LABOR AND MATERIALS

Copper } Connection	_____	\$	_____
Lead } _____	_____	\$	_____
Curb } Cock	} _____ in.	\$	_____
Valve			
T.S. & V.			
Service box } Short 3½ x 4½	} _____	\$	_____
Old returned } Long 4½ x 5½			
Ft. 3/4 in. } Copper	} Pipe at	\$	_____

Nipples	in. at	\$	_____
Bushings	to _____ in. at	\$	_____
Red'g } Inc'g	} Coupl'gs to _____ in. at	\$	_____
Union			
Meter	in. at	\$	_____
_____		\$	_____
Compound Joints	at	\$	_____
Maintenance Foreman		\$	_____
Hrs. Water Maint. Man-1	at	\$	_____
Hrs. Water Maint. Man-2	at	\$	_____
Hrs. Garage Foreman	at	\$	_____
Hrs. Labor	at	\$	_____
Hrs. Compressor	at	\$	_____
_____		\$	_____
Trucking		\$	_____
Pav't Patch		\$	_____
_____		\$	_____
_____		\$	_____
_____		\$	_____
_____		\$	_____

SOUTH

WESTERN

St. _____
 Pl. _____
 Ave. No. 43


Name of Owner

F. WESTFALL (DR. OFFICE)

TAX ID # 309.7-10-30

Labor and Mat'l. Report

1983

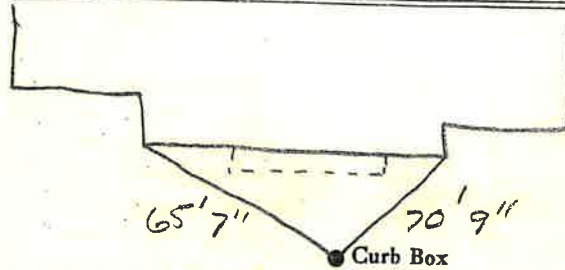

12" Main Elev. of Main at tap _____
 Gate at • • Gate at

• Curb Box