

LABOR AND MATERIALS

Copper } Connection _____	\$ _____
Lead } _____	
Curb } Cock _____	in. \$ _____
} Valve _____	
} T. S. & V. _____	
Service box } Short 3½ x 4½ _____	
Old returned } Long 4½ x 5½ _____	\$ _____
11 Ft. _____ in. } C.I. } C.I. } Pipe at _____	\$ _____
} Copper _____	
Nipples _____ in. at _____	\$ _____
Bushings _____ to _____ in. at _____	\$ _____
Red'g } _____	
Inc'g } Coupl'gs _____ to _____ in. at _____	\$ _____
Union _____ in. at _____	\$ _____
Meter _____ in. at _____	\$ _____
_____	\$ _____
Compound Joints at _____	\$ _____
Maintenance Foreman _____	\$ _____
Hrs. Water Maint. Man-1 at _____	\$ _____
Hrs. Water Maint. Man-2 at _____	\$ _____
Hrs. Garage Foreman _____ at _____	\$ _____
Hrs. Labor _____ at _____	\$ _____
Hrs. Compressor at _____	\$ _____
_____	\$ _____
Trucking _____	\$ _____
Pav't Patch _____	\$ _____
_____	\$ _____
_____	\$ _____
_____	\$ _____
_____	\$ _____

S. WESTERN


St. _____
Pl. _____
Ave. No. 49

Name of Owner

M. DUNCAN

Labor and Mat'l. Report

19

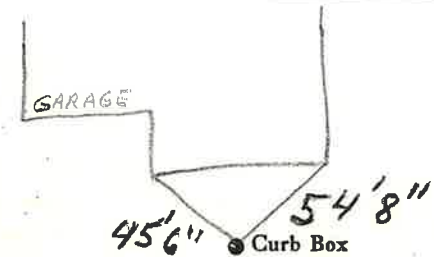

12" Main

Elev. of Main at tap _____

Gate at •

• Gate at

11' to main

• Curb Box

TAX ID # 309.7-4-9