


LABOR AND MATERIALS

1 Copper } Connection ^{3/4"} \$ _____
 1 Lead }
 1 Curb } Cock } 1/4 in. \$ _____
 } Valve }
 } F.S. & V. }
 1 Service box { Short 3 1/2 x 4 1/2 }
 Old returned { Long 4 1/2 x 5 1/2 } \$ _____
 } Buff or Rdway }
 12 Ft. ^{3/4} in. { Copper } Pipe at \$ _____
 } G.I. }
 } C.I. }
 Nipples in. at \$ _____
 Bushings to in. at \$ _____
 Red'g }
 Inc'g } Coupl'gs to in. at \$ _____
 Union in. at \$ _____
 Meter in. at \$ _____
 Lead Joints at \$ _____
 Compound Joints at \$ _____
 Maintenance Foreman \$ _____
 Hrs. Water Maint. Man—1 at \$ _____
 Hrs. Water Maint. Man—2 at \$ _____
 Hrs. Garage Foreman at \$ _____
 Hrs. Labor— at \$ _____
 Hrs. Compressor at \$ _____
 Compensation Ins. at \$ _____ per C. \$ _____
 Trucking \$ _____
 Pav't Patch \$ _____
 Tap by Gifford + Co. \$ _____
 6/20/57 \$ _____
 O'head \$ _____
 \$ _____

W.G.F. ✓
 Western Ave, South St.
 Corline Pt. Ave. No. 6

Name of Owner
 Leonard Wood

Labor and Mat'l. Report June 20 1957

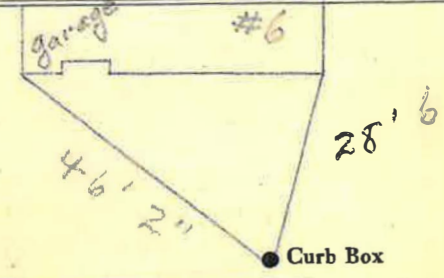

12" Main Elev. of Main at tap 5'

Gate at • Gate at

12' to main

• Curb Box

oct/22 not on map

TAX

2022 Not on map