

May 23, 2000



S. WESTERN


St. Pt. Ave. No. 10

Name of Owner

FORMER CURTISS LUMBER

6/23/2000
19

Labor and Mat'l. Report

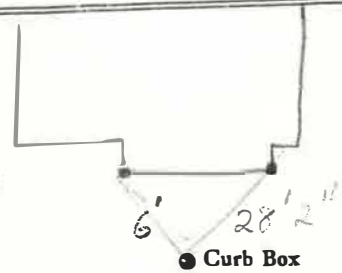

Main

Elev. of Main at tap

Gate at ●

Gate at ●

TAX ID # 309.7-1-2

QUEENSBURY

● Curb Box

