


LABOR AND MATERIALS

1. ~~Connection~~ } Lead Connection 3/4 \$ 1.80
 1. Curb } Cock Valve } T. S. & V. } 3/4 in. \$ 1.96
 1. Service Box } Old-returned } Short 3 1/2 x 4 1/2 } Long 4 1/2 x 5 1/2 } Buff or Rdway } \$ 1.82
 15 Ft. 3/4 in. } Copper } Galv Iron } Cast Iron } Pipe at 1/19 \$ 2.52
 Nipples in. at \$
 Bushings to in. at \$
 Red'g } Inc'g } Couplings to in. at \$
 Union in. at \$
 Meter in. at \$
 Lead Joints at \$
 Leadite Joints at \$
 Hrs. Foreman at \$
 2 Hrs. Chauffeur at 6.8314 \$ 1.38
 Hrs. Tapper at \$
 Hrs. Labor at \$
 Hrs. Labor at \$
 Hrs. Compressor at \$
 Compensation Ins. 2.669 \$.06
 Trucking \$ 1.00
 Builders Use of Water \$
 Top 4 Miller \$
 \$
 \$
 \$
 \$
 \$ 10.52

Replaced
 Tubloy with 3/4"
 Copper- May 16-59

33-44
 Western Ave. South. St.
 Pl. Ave. No. 18

Name of Owner
 Benway, Arthur L.
 Labor and Mat'l. Report Oct 31 1949

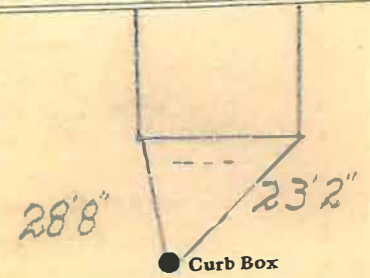

10 Main Elev. of Main at tap
 Gate at Gate at

15' MAIN

TAX ID # 309.7-1-4
 Queensbury