


City
Western So. Ave. No. 34

Name of Owner

Richard E. Bailey

Labor and Mat'l. Report

April 24 19 73

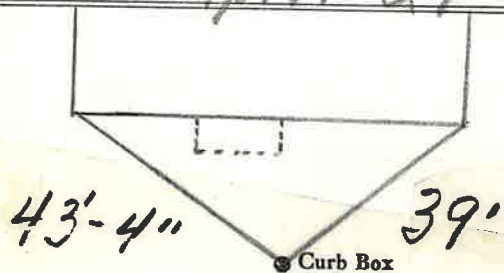

12" Main

Elev. of Main at tap 4 1/2'

Gate at ●

● Gate at

39' to MAIN

● Curb Box

Queensbury

Queensbury
Western Ave. South Ave. No. 34

Name of Owner

Jack Cross

Labor and Mat'l. Report

Aug. 7 19 69

Garage House



12" Main

Elev. of Main at tap 5'

Gate at ●

● Gate at

21' to MAIN

● Curb Box

LABOR AND MATERIALS

1 Copper } Connection $\frac{3}{4}$ " \$ _____
~~Lead~~
 1 Curb } Cock } $\frac{3}{4}$ in. (MAR RII) \$ _____
 } Valve } (ORISCHAI)
 } T.S. & V. }
 1 Service box { Short $3\frac{1}{2} \times 4\frac{1}{2}$ }
 Old returned { Long $4\frac{1}{2} \times 5\frac{1}{2}$ } \$ _____
 { Buff or Rdway }
 39 Ft. $\frac{3}{4}$ in. } Copper } Pipe at \$ _____
 } G.I. }
 } C.I. }
 Nipples _____ in. at \$ _____
 Bushings _____ to _____ in. at \$ _____
 Red'g }
 Inc'g } Coupl'gs _____ to _____ in. at \$ _____
 Union _____ in. at \$ _____
 Meter _____ in. at \$ _____
 Lead Joints at \$ _____
 Compound Joints at \$ _____
 Maintenance Foreman \$ _____
 Hrs. Water Maint. Man—1 at \$ _____
 Hrs. Water Maint. Man—2 at \$ _____
 Hrs. Garage Foreman _____ at \$ _____
 Hrs. Labor _____ at \$ _____
 Hrs. Compressor at \$ _____
 Compensation Ins. at \$ _____ per C \$ _____
 Trucking \$ _____
 Pav't Patch \$ _____
 Tap made By Peck & Co \$ _____
 O'head April-24-1973 \$ _____
 \$ _____

LABOR AND MATERIALS

1 Copper } Connection $\frac{3}{4}$ " \$ _____
 Lead }
 1 Curb } Cock } $\frac{3}{4}$ in. \$ _____
 } Valve }
 } T.S. & V. }
 1 Service box { Short $3\frac{1}{2} \times 4\frac{1}{2}$ }
 Old returned { Long $4\frac{1}{2} \times 5\frac{1}{2}$ } \$ _____
 { Buff or Rdway }
 21 Ft. $\frac{3}{4}$ in. } Copper } Pipe at \$ _____
 } G.I. }
 } C.I. }
 Nipples _____ in. at \$ _____
 Bushings _____ to _____ in. at \$ _____
 Red'g }
 Inc'g } Coupl'gs _____ to _____ in. at \$ _____
 Union _____ in. at \$ _____
 Meter _____ in. at \$ _____
 Lead Joints at \$ _____
 Compound Joints at \$ _____
 Maintenance Foreman \$ _____
 Hrs. Water Maint. Man—1 at \$ _____
 Hrs. Water Maint. Man—2 at \$ _____
 Hrs. Garage Foreman _____ at \$ _____
 Hrs. Labor _____ at \$ _____
 Hrs. Compressor at \$ _____
 Compensation Ins. at \$ _____ per C \$ _____
 Trucking \$ _____
 Pav't Patch \$ _____
 Tap by Lapeau & Co \$ _____
 8-7-69 \$ _____
 O'head \$ _____
 \$ _____