

## LABOR AND MATERIALS

Copper	} Connection	_____	\$ _____
Lead			
Curb	} Cock Valve	_____ in.	\$ _____
	} T. S. & V.		
Service box	} Short 3½ x 4½	_____	\$ _____
Old returned			
Ft. _____ in.	} Copper	} Pipe at _____	\$ _____
	} G. I.		
	} C. I.		
Nipples	_____ in. at _____	\$ _____	
Bushings	_____ to _____ in. at _____	\$ _____	
Red'g	} Coupl'gs. _____ to _____ in. at _____	\$ _____	
Inc'g			
Union	_____ in. at _____	\$ _____	
Meter	_____ in. at _____	\$ _____	
		\$ _____	
	Compound Joints at _____	\$ _____	
	Maintenance Foreman _____	\$ _____	
	Hrs. Water Maint. Man—1 at _____	\$ _____	
	Hrs. Water Maint. Man—2 at _____	\$ _____	
	Hrs. Garage Foreman _____ at _____	\$ _____	
	Hrs. Labor _____ at _____	\$ _____	
	Hrs. Compressor at _____	\$ _____	
		\$ _____	
	Trucking _____	\$ _____	
	Pav't Patch _____	\$ _____	
		\$ _____	
		\$ _____	
		\$ _____	
		\$ _____	


~~St.~~  
~~Pl.~~  
 Ave. No. 19

WESTERN

Name of Owner \_\_\_\_\_

TAX ID # 302.19-13-15

Labor and Mat'l. Report 19

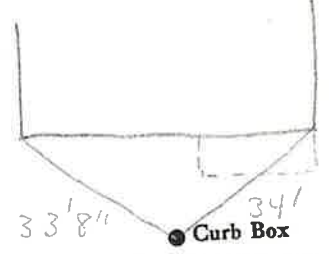

	Elev. of
Main	Main at tap _____
Gate at ●	● Gate at _____

● Curb Box