

LABOR AND MATERIALS

1	Copper Lead	Connection	3/4"	\$	3.08
1	Curb	Cock Valve T. S. & V.	3/4 in.	\$	3.89
1	Service box Old returned	Short 3 1/2 x 4 1/2 Long 4 1/2 x 5 1/2 Buff or Rdway		\$	4.32
47	Ft.	Copper C.I. C.I.	3/4 in. Pipe at	45	\$ 18.90
	Nipples	in. at		\$	
	Bushings	to in. at		\$	
	Red'g Inc'g	Coupl'gs to in. at		\$	
	Union	in. at		\$	
	Meter	in. at		\$	
	Lead Joints	at		\$	
	Compound Joints	at		\$	
	Maintenance Foreman			\$	
	Hrs. Water Maint. Man-1	at		\$	
2	Hrs. Water Maint. Man-2	at	1.613	\$	3.23
	Hrs. Garage Foreman	at		\$	
	Hrs. Labor	at		\$	
	Hrs. Compressor	at		\$	
	Compensation Ins. at	\$5.686 per C		\$	18
	Trucking			\$	1.50
	Pav't Patch	outside		\$	
	Tap	July 31-56		\$	
	by	Goldst & Miller		\$	
	O'head			\$	
				\$	35.10


Billed 177
 8.50
 26.60

(North) ✓

Western Ave ^{St.} _{Pt.} Ave. No. 24

Name of Owner
 Dr. Robert Linchan

Labor and Mat'l. Report July 31 19 56

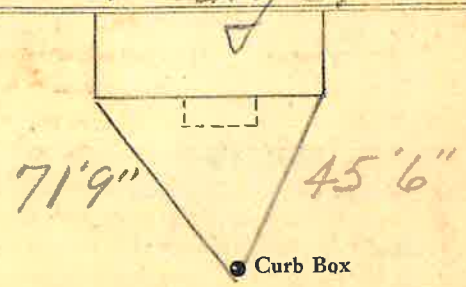

12" Main Elev. of Main at tap 4 1/2'

Gate at • Gate at •
 42' to main

• Curb Box

10/22 - Not on map