

LABOR AND MATERIALS

1	Copper Lead	Connection	3/4"	\$	2.41
1	Curb	Cock Valve T.S. & V.	3/4 in.	\$	3.41
1	Service box	Old returned	Short 3 1/2 x 4 1/2	\$	4.18
			Long 4 1/2 x 5 1/2		
34	Pt.	Copper G.I. C.I.	3/4 in. Pipe at 40	\$	13.60
	Nipples	in. at		\$	
	Bushings	to in. at		\$	
	Red'g Inc'g	Coupl'gs. to in. at		\$	
	Union	in. at		\$	
	Meter	in. at		\$	
	Lead Joints	at		\$	
	Compound Joints	at		\$	
	Maintenance Foreman			\$	
	Hrs. Water Maint. Man-1	at		\$	
	Hrs. Water Maint. Man-2	at		\$	
2	Hrs. Garage Foreman	at 1.59	\$	3.18	
12	Hrs. Labor	at 1.13	\$	13.56	
	Hrs. Compressor	at		\$	
	Compensation Ins.	at \$3861 per C	\$	65	
	Trucking		\$	1.50	
	Pav't Patch		\$	7.20	
	Tap by Larreau	10-1-54	\$		
	O'head		\$		
			\$	49.99	


42.49

75-54 North

Western St. Pl. Ave. No. 4

Name of Owner  
Ormstrup

Labor and Mat'l. Report Oct. 1 19 54

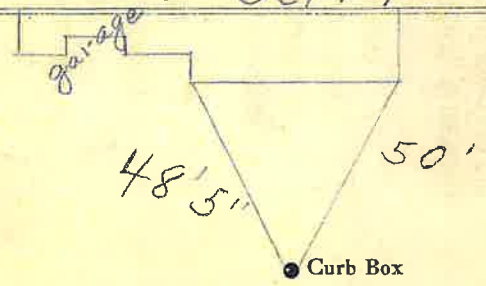

12" Main Elev. of Main at tap 4 1/2'

Gate at • Gate at

34' to main

• Curb Box

TAX ID# 302.19-12-2