

LABOR AND MATERIALS

1	Copper	{ Connection	3/4"	\$	3.04
	Lead				
1	Curb	{ Cock Valve	3/4" in.	\$	3.54
		{ T. S. & V.			
1	Service box	{ Short 3 1/2 x 4 1/2		\$	4.70
	Old returned	{ Long 4 1/2 x 5 1/2		\$	
		{ Buff or Rdway		\$	
45'	45' 3/4" in.	{ Copper	Pipe at 35	\$	8.75
		{ G. I.		\$	
		{ C. I.		\$	
	Nipples	in. at		\$	
	Bushings	to in. at		\$	
	Red'g	{ Coupl'gs to in. at		\$	
	Inc'g			\$	
	Union	in. at		\$	
	Meter	in. at		\$	
	Lead Joints	at		\$	
	Compound Joints	at		\$	
	Hrs. Water Maint. Man-1	at		\$	
4	Hrs. Water Maint. Man-2	at 1.13		\$	4.52
2	Hrs. Labor	at 1.02		\$	2.04
	Hrs. Labor	at		\$	
	Hrs. Compressor	at		\$	
	Compensation Ins. at \$2.66	per C.		\$	17
	Trucking			\$	1.05
	Pav't Patch			\$	
				\$	
				\$	
	O'head			\$	
				\$	27.76

8.00

New Tap made by
Gifford June 20-1951

621501

North

Western

St.
Pt.
Ave. No. 58


Name of Owner

Berndt.

Labor and Mat'l. Report

June 20

1951

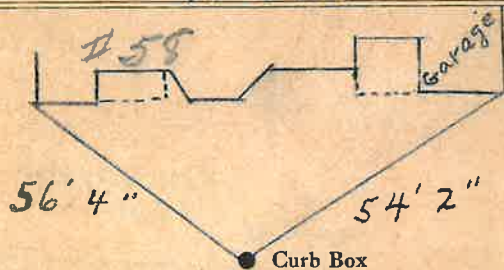

12" Main

Elev. of
Main at tap 2'

Gate at ●

● Gate at

45' to main

● Curb Box

Quansbury