

LABOR AND MATERIALS

1	Copper Lead	Connection	3/4"	\$	2.41
1	Curb	Cock Valve T-S. & V.	3/4 in.	\$	3.41
1	Service box Old returned	Short 3 1/2 x 4 1/2 Long 4 1/2 x 5 1/2 Buff or Rdway		\$	4.18
36	Ft. 3/4 in.	Copper G.I. C.I.	Pipe at 40	\$	14.40
	Nipples	in. at		\$	
	Bushings	to in. at		\$	
	Red'g Inc'g	Coupl'gs to in. at		\$	
	Union	in. at		\$	
	Meter	in. at		\$	
	Lead Joints at			\$	
	Compound Joints at			\$	
	Maintenance Foreman			\$	
	Hrs. Water Maint. Man-1 at			\$	
7	Hrs. Water Maint. Man-2 at	1.24		\$	8.68
	Hrs. Garage Foreman at			\$	
16	Hrs. Labor at	1.13		\$	18.08
	Hrs. Compressor at			\$	
	Compensation Ins. at \$3.861 per C.			\$	1.03
	Trucking			\$	1.50
	Pav't Patch			\$	
	Tap by Gifford	6-30-54		\$	
	O'head			\$	
				\$	53.69


Bill 11/7
474
4885

24-54 North

Western St. Pl. Ave. No. 6

Name of Owner Traver

Labor and Mat'l. Report June 30 1954

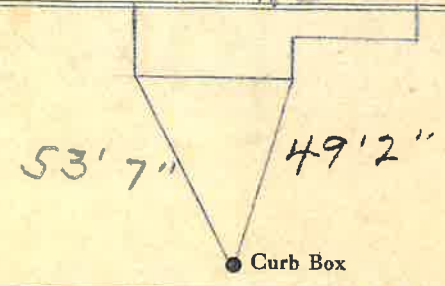

12" Main Elev. of Main at tap 4 1/2"

Gate at • Gate at

36' to man

• Curb Box

TAX ID # 302.19-12-3