

LABOR AND MATERIALS

1	Copper	Connection	$\frac{3}{4}$ "	\$
1	Lead	Cock	$\frac{3}{4}$ in.	\$
1	Curb	Valve		\$
		T. S. & V.		\$
1	Service box	Short $3\frac{1}{2} \times 4\frac{1}{2}$		\$
	Old returned	Long $4\frac{1}{2} \times 5\frac{1}{2}$		\$
		Buff or Rdway		\$
13	Ft.	Copper	$\frac{3}{4}$ in.	\$
		G.I.		\$
		G.I.		\$
		Pipe at		\$
	Nipples	in. at		\$
	Bushings	to in. at		\$
	Red'g	Coupl'gs	to in. at	\$
	Inc'g			\$
	Union	in. at		\$
	Meter	in. at		\$
	Lead Joints at			\$
	Compound Joints at			\$
	Maintenance Foreman			\$
	Hrs. Water Maint. Man-1 at			\$
	Hrs. Water Maint. Man-2 at			\$
	Hrs. Garage Foreman at			\$
	Hrs. Labor at			\$
	Hrs. Compressor at			\$
	Compensation Ins. at \$	per C		\$
	Trucking			\$
	Pav't Patch			\$
	Tap by Gissouri Co.			\$
	3-27-58			\$
	O'head			\$
				\$

North

Western


St. 1
Pl.
Ave. No. 9

Name of Owner

Fratamico

Labor and Mat'l. Report

Mar. 27 1958

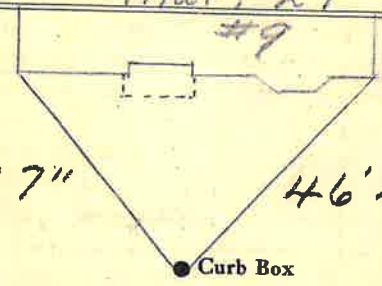

12" Main

Elev. of Main at tap 4 1/2'

Gate at ●

● Gate at

13' to main

● Curb Box

TAX ID# 302.19-13-19