

### LABOR AND MATERIALS

Copper	} Connection			\$	
Lead					
Curb	} Cock Valve	} in.		\$	
	T. S. & V.				
Service box	} Short 3½ x 4½	}		\$	
Old returned					Long 4½ x 5½
Ft.	} Copper	} Pipe at		\$	
in.					G. I.
					C. I.
Nipples	in.	at		\$	
Bushings	to	in.	at	\$	
Red'g	} Coupl'gs	to	in.	at	
Inc'g					
Union	in.	at		\$	
Meter	in.	at		\$	
				\$	
Compound Joints	at			\$	
Maintenance Foreman				\$	
Hrs. Water Maint. Man-1	at			\$	
Hrs. Water Maint. Man-2	at			\$	
Hrs. Garage Foreman	at			\$	
Hrs. Labor	at			\$	
Hrs. Compressor	at			\$	
				\$	
Trucking				\$	
Pav't Patch				\$	
				\$	
				\$	
				\$	
				\$	

N. WESTERN


St. 11  
 Pt. 11  
 Ave. No. 11

Name of Owner \_\_\_\_\_

TAX ID # 302.19-13-18

Labor and Mat'l. Report \_\_\_\_\_

19

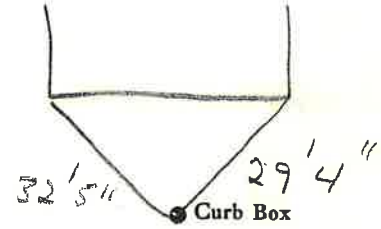

\_\_\_\_\_ Main Elev. of Main at tap \_\_\_\_\_

Gate at • • Gate at

• Curb Box