

LABOR AND MATERIALS

1	Copper	{ Connection	3/4		\$ 2.87
	Lead				
1	Curb	{ Cock Valve	3/4 in.		\$ 3.62
		T.S. & V.			
1	Service box	{ Short 3 1/2 x 4 1/2			4.68
	Old returned	{ Long 4 1/2 x 5 1/2			
		Buff or Rdway			
36	Ft.	{ Copper	Pipe at 32		\$ 5.44
	3/4 in.	{ G.I.			
		{ G.I.	Billup 19 ft		
	Nipples	in. at			\$
	Bushings	to in. at			\$
	Red'g	{ Coupl'gs	to in. at		\$
	Inc'g				\$
	Union	in. at			\$
	Meter	in. at			\$
	Lead Joints	at			\$
	Compound Joints	at			\$
	Hrs. Water Maint. Man	1 at			\$
3	Hrs. Water Maint. Man	2 at	1.07		\$ 3.06
2	Hrs. Labor	at	.91		\$ 1.82
	Hrs. Labor	at			\$
	Hrs. Compressor	at			\$
	Compensation Ins.	at \$ 2.18 per C.			\$ 1.11
	Trucking				\$ 2.00
	Pav't Patch				\$
	Tap by <i>W. H. H. H. H.</i>				\$
	O'head				\$ 23.60

123

North

Western


St.
Pl.
Ave. No. 14

Name of Owner TAX # 302.19-12-7

Dilmar

Labor and Mat'l. Report Nov 3 1949

See Below

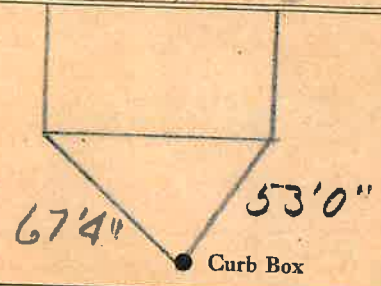

12 Main Elev. of Main at tap 5

Gate at ● Gate at ●

36' to MAIN

