


LABOR AND MATERIALS

1	Copper	} Connection	3/4"	\$
1	Lead			
1	Curb	} Cock Valve	3/4 in. Oriseal.	\$
			T.S. & V.	
1	Service box	} { Short 3 1/2 x 4 1/2 Long 4 1/2 x 5 1/2 Buff or Rdway		\$
	Old returned			
23	Ft. 3/4 in.		{ Copper G.I. G.I.	Pipe at
	Nipples	in. at		\$
	Bushings	to in. at		\$
	Red'g } Inc'g }	Coupl'gs	to in. at	\$
	Union	in. at		\$
	Meter	in. at		\$
	Lead Joints	at		\$
	Compound Joints	at		\$
	Maintenance Foreman			\$
	Hrs. Water Maint. Man-1	at		\$
	Hrs. Water Maint. Man-2	at		\$
	Hrs. Garage Foreman	at		\$
	Hrs. Labor	at		\$
	Hrs. Compressor	at		\$
	Compensation Ins. at \$	per C		\$
	Trucking			\$
	Pav't Patch			\$
	Tap by <i>Konovan &amp; Co.</i>			\$
	<i>8-21-69.</i>			\$
	O'head			\$

St. William  
Pl. 5  
Ave. No. 5

Name of Owner Michael Lockwood

Labor and Mat'l. Report Aug. 21 1969

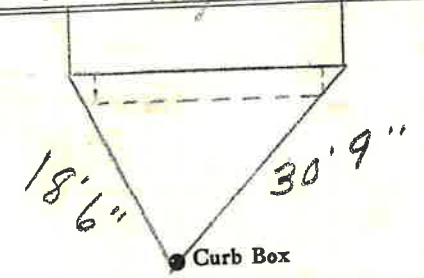

4" Main Elev. of Main at tap 5'

Gate at • Gate at  
23' to main

• Curb Box

TAX ID # 302.16.17-24