


William St. Pl. Ave. No. 14
Name of Owner

Labor and Mat'l. Report 15 10/12/07

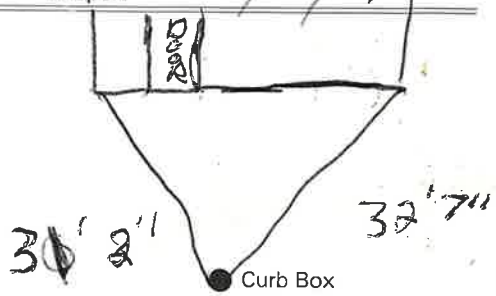

6" Main Elev. of Main at tap 4"

Gate at • Gate at •

TAX ID # 302.16-15-33


• Curb Box

NEW TAP ON 6"
MAIN OLD SHUT AT
~~OFF OLD MAIN~~
OLD MAIN

5' to NEW MAIN •

William St. Pl. Ave. No. 14
Name of Owner

Labor and Mat'l. Report 19 23

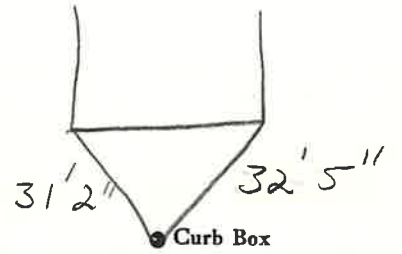

4 Main Elev. of Main at tap 4 1/2

Gate at • Gate at •

12' to MAIN

• Curb Box

LABOR AND MATERIALS

Copper } Connection _____ \$ _____
 Lead }
 Curb } Cock } _____ in. _____ \$ _____
 } Valve }
 } T.S. & V. }
 Service box { Short 3-1/2 x 4-1/2 } _____ \$ _____
 Old returned { Long 4-1/2 x 5-1/2 }
 5 Ft. _____ in. { Copper } Pipe at _____ \$ _____
 } G.I. } *NEW MAIN*
 } C.I. }
 Nipples _____ in. at _____ \$ _____
 Bushings _____ to _____ in. at _____ \$ _____
~~Red'g~~
~~Inc'g~~ *11 feet old MAIN*
 Union _____ in. at _____ \$ _____
~~Meter~~ _____ in. at _____ \$ _____
 _____ \$ _____
 Compound Joints at _____ \$ _____
 Maintenance Foreman _____ \$ _____
 Hrs. Water Maint. Man - 1 at _____ \$ _____
 Hrs. Water Maint. Man - 2 at _____ \$ _____
 Hrs. Garage Foreman _____ at _____ \$ _____
 Hrs. Labor _____ at _____ \$ _____
 Hrs. Compressor at _____ \$ _____
 _____ \$ _____
 Trucking _____ \$ _____
 Pav't Patch _____ \$ _____
 _____ \$ _____
 _____ \$ _____
LABOR AND MATERIALS

Copper } Connection _____ \$ _____
 Lead }
 Curb } Cock } _____ in. _____ \$ _____
 } Valve }
 } T.S. & V. }
 Service box { Short 3 1/2 x 4 1/2 } _____ \$ _____
 Old returned { Long 4 1/2 x 5 1/2 }
 12 Ft. 3/4 in. { Copper } Pipe at _____ \$ _____
 } G.I. }
 } C.I. }
 Nipples _____ in. at _____ \$ _____
 Bushings _____ to _____ in. at _____ \$ _____
 Red'g }
 Inc'g } Coupl'gs _____ to _____ in. at _____ \$ _____
 Union _____ in. at _____ \$ _____
 Meter _____ in. at _____ \$ _____
 _____ \$ _____
 Compound Joints at _____ \$ _____
 Maintenance Foreman _____ \$ _____
 Hrs. Water Maint. Man—1 at _____ \$ _____
 Hrs. Water Maint. Man—2 at _____ \$ _____
 Hrs. Garage Foreman _____ at _____ \$ _____
 Hrs. Labor _____ at _____ \$ _____
 Hrs. Compressor at _____ \$ _____
 _____ \$ _____
 Trucking _____ \$ _____
 Pav't Patch _____ \$ _____
 _____ \$ _____
 _____ \$ _____
 _____ \$ _____
 _____ \$ _____