


LABOR AND MATERIALS

1 Copper } Connection 3/4" \$
 Lead }
 — Curb } Cock } 3/4" Used old \$
 } Valve }
 } T. S. & V. }
 — Service box } Short 3 1/2 x 4 1/2 } Used old
 Old returned } Long 4 1/2 x 5 1/2 }
 } Buff or Rdway }
90" 3/4 in. } Copper } Pipe at \$
 } ~~Curb~~ }
 } ~~Curb~~ }
 Nipples in. at \$
 Bushings to in. at \$
 Red'g }
 Inc'g } Coupl'gs. to in. at \$
 Union in. at \$
 Meter in. at \$
 1 Lead Joint at Male Adapter \$
 Compound Joints at \$
 Maintenance Foreman \$
 Hrs. Water Maint. Man—1 at \$
 Hrs. Water Maint. Man—2 at \$
 Hrs. Garage Foreman at \$
 Hrs. Labor— at \$
 Hrs. Compressor at \$
 Compensation Ins. at \$ per C \$
 Trucking \$
 Pav't Patch \$
Tap Made By Peck & Co \$
 O'head 10-13-1977 \$
 \$

St. Williams
 Ave. No. 16

Name of Owner
Ernest Whitting

Labor and Mat'l. Report Oct 13 1971

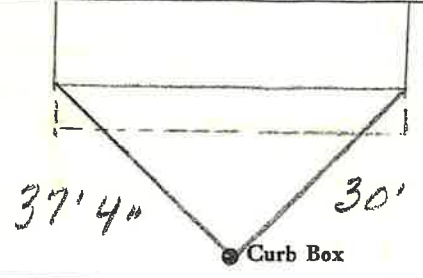

4" Main Elev. of Main at tap 5'
 Gate at • Gate at
9'7" to main
 • Curb Box

TAX ID# 302.16-15-34