

LABOR AND MATERIALS

1	Copper	Connection	3/4	\$	
	Lead				
1	Curb	Cock Valve	3/4 in.	\$	
		T.S. & V.			
1	Service box	Short 3 1/2 x 4 1/2		\$	
	Old returned	Long 4 1/2 x 5 1/2			
		Buff or Rdway			
19	Ft.	3/4 in.	Copper G.I. G.I.	Pipe at	\$
	Nipples	in.	at		\$
	Bushings	to	in.	at	\$
	Red'g				\$
	Inc'g	Coupl'gs	to	in.	at
	Union	in.	at		\$
	Meter	in.	at		\$
	Lead Joints	at			\$
	Compound Joints	at			\$
	Maintenance Foreman				\$
	Hrs. Water Maint. Man-1	at			\$
	Hrs. Water Maint. Man-2	at			\$
	Hrs. Garage Foreman	at			\$
	Hrs. Labor	at			\$
	Hrs. Compressor	at			\$
	Compensation Ins.	at \$	per C		\$
	Trucking				\$
	Pav't Patch				\$
	Tap by St. John				\$
	+ Co 11/13/78				\$
	O'head				\$


William

St. Pl. Ave. No. 19

Name of Owner

M. Sweeney

Labor and Mat'l. Report Nov 13 1978

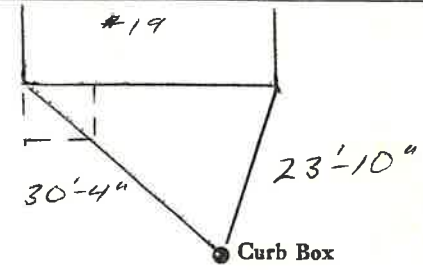

4" Main

Elev. of Main at tap 5'

Gate at ●

● Gate at

19' to main

● Curb Box

TAX ID# 302.16-17-17