


LABOR AND MATERIALS

1	Copper Lead	} Connection	3/4"	\$
1	Curb			} Cock Valve T.S. & V.
1	Service box Old returned	} Short 3 1/2 x 4 1/2 Long 4 1/2 x 5 1/2 Buff or Rdway		
26	Ft. 3/4 in.		} Copper C.I. C.I.	} Pipe at
	Nipples	in. at		
	Bushings	to in. at	\$	
	Red'g } Inc'g }	} Coupl'gs	to in. at	\$
	Union			
	Meter	in. at	\$	
	Lead Joints	at	\$	
	Compound Joints	at	\$	
	Maintenance Foreman		\$	
	Hrs. Water Maint. Man-1	at	\$	
	Hrs. Water Maint. Man-2	at	\$	
	Hrs. Garage Foreman	at	\$	
	Hrs. Labor	at	\$	
	Hrs. Compressor	at	\$	
	Compensation Ins.	at \$ per C.	\$	
	Trucking		\$	
	Pav't Patch		\$	
	Tap by Giggord & Co.		\$	
		9-16-63	\$	
	O'head		\$	
			\$	

William St. Pl. Ave. No. 21

Name of Owner  
Manuel Pissare

Labor and Mat'l. Report Sept. 16 1963

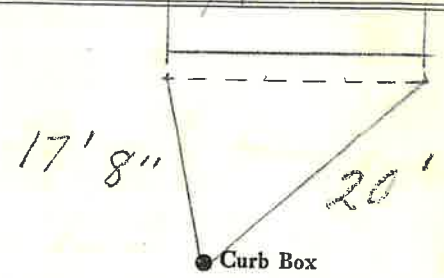

4" Main Elev. of Main at tap 5 1/2'

Gate at • Gate at  
20' to MAIN

• Curb Box

TAX ID# 302.16-17-16