


LABOR AND MATERIALS

|    |                         |                     |                             |    |
|----|-------------------------|---------------------|-----------------------------|----|
| 1  | Copper Lead             | Connection          | 3/4"                        | \$ |
| 1  | Curb                    | Cock Valve          | 3/4 in. (MARK II) (OYISRAI) | \$ |
| 1  | Service box             | Short 3 1/2 x 4 1/2 |                             | \$ |
|    | Old returned            | Long 4 1/2 x 5 1/2  |                             | \$ |
|    |                         | Buff or Rdway       |                             | \$ |
| 24 | Ft. 3/4 in.             | Copper Pipe         |                             | \$ |
|    | Nipples                 | in. at              |                             | \$ |
|    | Bushings                | to in. at           |                             | \$ |
|    | Red'g                   |                     |                             | \$ |
|    | Inc'g                   | Coupl'gs to in. at  |                             | \$ |
|    | Union                   | in. at              |                             | \$ |
|    | Meter                   | in. at              |                             | \$ |
|    | Lead Joints             | at                  |                             | \$ |
|    | Compound Joints         | at                  |                             | \$ |
|    | Maintenance Foreman     |                     |                             | \$ |
|    | Hrs. Water Maint. Man-1 | at                  |                             | \$ |
|    | Hrs. Water Maint. Man-2 | at                  |                             | \$ |
|    | Hrs. Garage Foreman     | at                  |                             | \$ |
|    | Hrs. Labor              | at                  |                             | \$ |
|    | Hrs. Compressor         | at                  |                             | \$ |
|    | Compensation Ins. at \$ | per C               |                             | \$ |
|    | Trucking                |                     |                             | \$ |
|    | Pav't Patch             |                     |                             | \$ |
|    | TAP MADE BY             | Beecher & Co        |                             | \$ |
|    | O'head                  | JUNE 19-1973        |                             | \$ |

St. No. 29  
 Ave. No. 29  
 Name of Owner  
 WILLIAM  
 CONSTANTINE DZIAMBO

Labor and Mat'l. Report JUNE 19 1973

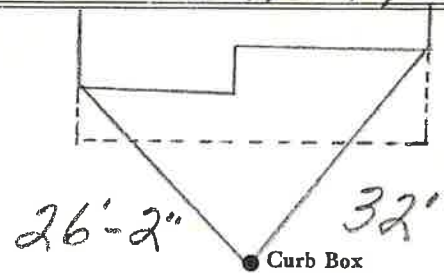

4" Main Elev. of Main at tap 4 1/2'

Gate at • Gate at

24' to main

• Curb Box

TAX ID# 302.16-17-12