

LABOR AND MATERIALS

1	Copper	Connection	3/4"	\$ 2.76
1	Lead	Cock	3/4"	\$ 3.49
1	Curb	Valve	3/4 in.	\$ 4.94
		T. S. & V.		
1	Service box	Short 3 1/2 X 4 1/2		\$ 4.94
	Old returned	Long 4 1/2 X 5 1/2		
		Buff or Rdway		
11	Ft.	Copper	Pipe at 38	\$ 4.18
		S.I.		
		C.I.		
	Nipples	in. at		\$
	Bushings	to in. at		\$
	Red'g			\$
	Inc'g	Coupl'gs to in. at		\$
	Union	in. at		\$
	Meter	in. at		\$
	Lead Joints at			\$
	Compound Joints at			\$
	Hrs. Water Maint. Man	1 at		\$ 29.50
5	Hrs. Water Maint. Man	2 at	1.59	\$ 7.95
2.8	Hrs. Labor	at	1.13	\$ 31.64
	Hrs. Labor	at		\$
1	Hrs. Compressor at			\$ 1.50
	Compensation Ins. at	\$ 4.406 per C		\$ 1.74
	Trucking			\$ 1.00
	Pav't Patch			\$
	Tap by Lareau	9-18-53		\$ 8.96
	O'head			\$
				\$ 67.96


59.00

7153

William St. Pt. Ave. No. 30

Name of Owner  
DuCuennois

Labor and Mat'l. Report Sept. 18 1953

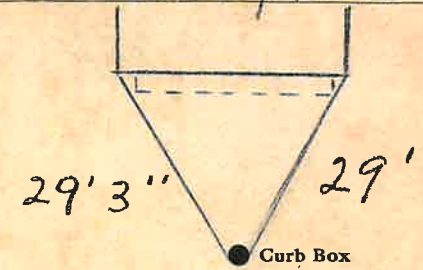

4" Main Elev. of Main at tap 4'

Gate at ● Gate at ●

11' to MAIN

● Curb Box

TAX ID # 302.16-15-41