


William

St. ~~Pl.~~  
Ave. No. 8

Name of Owner

Calvin Howard Jr.

Labor and Mat'l. Report July 2, 1975

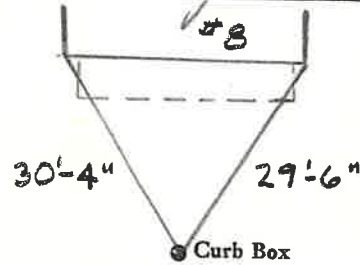

4" Main

Elev. of Main at tap 5 1/2'

Gate at •

• Gate at

11' to MAIN

• Curb Box

TAX ID # 302.16-15-30

LSM-5C-6-1-67


William

St. ~~Pl.~~  
Ave. No. 8

Name of Owner

Calvin Howard Jr.

Labor and Mat'l. Report July 2, 1975

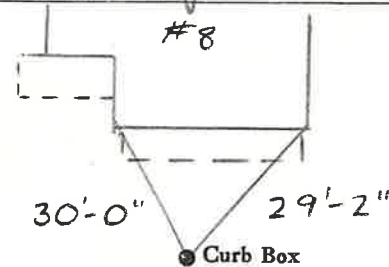

4" Main

Elev. of Main at tap 5'

Gate at •

• Gate at

• Curb Box

LSM-5C-6-1-67

VGL

LABOR AND MATERIALS

1	Copper Lead	Connection	$\frac{3}{4}$ "	\$	
1	Curb	Cock Valve T.S. & V.	$\frac{3}{4}$ "	\$	
1	Service box Old returned	Short $3\frac{1}{2}$ x $4\frac{1}{2}$ Long $4\frac{1}{2}$ x $5\frac{1}{2}$ Buff or Rdway	$5\frac{1}{2}$ x $6'$	\$	
13	Ft.	$\frac{3}{4}$ in. { Copper C.I. C.I.	Pipe at	\$	
	Nipples	in. at		\$	
	Bushings	to in. at		\$	
	Red'g Inc'g	Coupl'gs	to in. at	\$	
	Union	in. at		\$	
	Meter	in. at		\$	
	Lead Joints	at		\$	
	Compound Joints	at		\$	
	Maintenance Foreman			\$	
	Hrs. Water Maint. Man	—1 at		\$	
	Hrs. Water Maint. Man	—2 at		\$	
	Hrs. Garage Foreman	at		\$	
	Hrs. Labor	at		\$	
	Hrs. Compressor	at		\$	
	Compensation Ins.	at \$ per C		\$	
	Trucking			\$	
	Pav't Patch			\$	
				\$	
				\$	
	O'head			\$	
				\$	

LABOR AND MATERIALS

1	Copper Lead	Connection	$\frac{3}{4}$ "	\$	
1	Curb	Cock Valve T.S. & V.	$\frac{3}{4}$ "	\$	
1	Service box Old returned	Short $3\frac{1}{2}$ x $4\frac{1}{2}$ Long $4\frac{1}{2}$ x $5\frac{1}{2}$ Buff or Rdway		\$	
11	Ft.	$\frac{3}{4}$ in. { Copper C.I. C.I.	Pipe at	\$	
	Nipples	in. at		\$	
	Bushings	to in. at		\$	
	Red'g Inc'g	Coupl'gs	to in. at	\$	
	Union	in. at		\$	
	Meter	in. at		\$	
	Lead Joints	at		\$	
	Compound Joints	at		\$	
	Maintenance Foreman			\$	
	Hrs. Water Maint. Man	—1 at		\$	
	Hrs. Water Maint. Man	—2 at		\$	
	Hrs. Garage Foreman	at		\$	
	Hrs. Labor	at		\$	
	Hrs. Compressor	at		\$	
	Compensation Ins.	at \$ per C		\$	
	Trucking			\$	
	Pav't Patch			\$	
				\$	
				\$	
	O'head			\$	
				\$	

Tap July 2, 1975  
by Fosdick & Co.