


LABOR AND MATERIALS

| | | | |
|----|--------------------------------|--|--------------|
| 1 | Copper | } Connection ^{3/4"} | \$ |
| | Lead | | |
| 1 | Curb | } ^{3/4} in. <i>oriseat</i> | \$ |
| | Valve | | |
| | T.S. & V. | | |
| | Service box | } { Short 3 1/2 x 4 1/2 Long 4 1/2 x 5 1/2 Buff or Rdway } | \$ |
| | Old returned | | |
| | | | |
| 26 | Ft. ^{3/4} in. | } { Copper G.I. G.I. } | Pipe at \$ |
| | | | |
| | Nipples | in. at | \$ |
| | Bushings | to in. at | \$ |
| | Red'g | } Coupl'gs | to in. at \$ |
| | Inc'g | | |
| | Union | in. at | \$ |
| | Meter | in. at | \$ |
| | Lead Joints | at | \$ |
| | Compound Joints | at | \$ |
| | Maintenance Foreman | | \$ |
| | Hrs. Water Maint. Man-1 | at | \$ |
| | Hrs. Water Maint. Man-2 | at | \$ |
| | Hrs. Garage Foreman | at | \$ |
| | Hrs. Labor | at | \$ |
| | Hrs. Compressor | at | \$ |
| | Compensation Ins. at \$ | per C | \$ |
| | Trucking | | \$ |
| | Pav't Patch | | \$ |
| | <i>Tap by Seymour & Co</i> | | \$ |
| | <i>4-21-70</i> | | \$ |
| | O'head | | \$ |
| | | | \$ |

St. William
 Pl. 45
 Ave. No. 45

Name of Owner
Ellen P. Rose.

Labor and Mat'l. Report April 21 1970

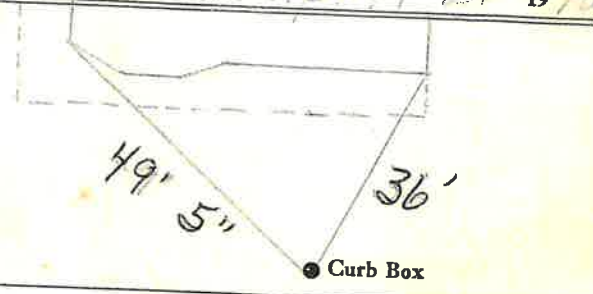

4\" Main Elev. of Main at tap 5-6'

Gate at ● Gate at ●

26' to main

● Curb Box

TAX ID # 302.16-17-5