

LABOR AND MATERIALS

1	Copper	Connection	3/4"	\$
1	Curb	Cock Valve T.S. & V.	3/4" in.	\$
1	Service box Old returned	Short 3 1/2 x 4 1/2 Long 4 1/2 x 5 1/2 Buff. or Rdway		\$
10	Ft. 8 in.	Copper C.I. C.I.	Pipe at 3/4"	\$
	Nipples	in. at		\$
	Bushings	to in. at		\$
	Red'g Inc'g	Coupl'gs	to in. at	\$
	Union	in. at		\$
	Meter	in. at		\$
	Lead Joints	at		\$
	Compound Joints	at		\$
	Maintenance Foreman			\$
	Hrs. Water Maint. Man-1	at		\$
	Hrs. Water Maint. Man-2	at		\$
	Hrs. Garage Foreman	at		\$
	Hrs. Labor	at		\$
	Hrs. Compressor	at		\$
	Compensation Ins.	at \$ per C		\$
	Trucking			\$
	Pav't Patch			\$
	Tap by Treceno			\$
	July 10, 1979			\$
	O'head			\$
				\$


O'C Jones

William

St. Ave. No. 46

Name of Owner

Labor and Mat'l. Report July 10 1979

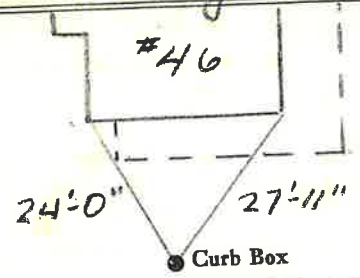

4" Main

Elev. of Main at tap 5'

Gate at

Gate at

10' to main

Curb Box

TAX ID# 302.16-16-13