

LABOR AND MATERIALS

Copper } Connection	_____	\$ _____
Lead } _____	_____	\$ _____
Curb } Cock	_____ in.	\$ _____
} Valve	_____	\$ _____
} T. S. & V.	_____	\$ _____
Service box } Short 3 1/2 x 4 1/2	_____	\$ _____
Old returned } Long 4 1/2 x 5 1/2	_____	\$ _____
11 Ft. 3/4 in. } Copper	_____ Pipe at	\$ _____
} G.I.	_____	\$ _____
} G.I.	_____	\$ _____
Nipples _____ in. at	_____	\$ _____
Bushings _____ to _____ in. at	_____	\$ _____
Red'g } Coupl'gs _____ to _____ in. at	_____	\$ _____
Inc'g } _____	_____	\$ _____
Union _____ in. at	_____	\$ _____
Meter _____ in. at	_____	\$ _____
_____	_____	\$ _____
Compound Joints at	_____	\$ _____
Maintenance Foreman	_____	\$ _____
Hrs. Water Maint. Man—1 at	_____	\$ _____
Hrs. Water Maint. Man—2 at	_____	\$ _____
Hrs. Garage Foreman _____ at	_____	\$ _____
Hrs. Labor— _____ at	_____	\$ _____
Hrs. Compressor at	_____	\$ _____
_____	_____	\$ _____
Trucking _____	_____	\$ _____
Pav't Patch _____	_____	\$ _____
_____	_____	\$ _____
_____	_____	\$ _____
WILLIAM


St. ~~Pt.~~ 48
Ave. No.

Name of Owner

TAX ID # 302.16-16-14

Labor and Mat'l. Report

19 90

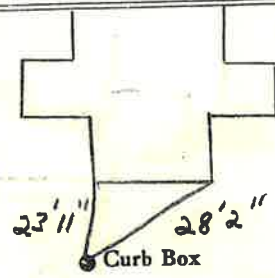

● Curb Box

Main

Elev. of Main at tap 6"

Gate at ●

● Gate at

11' to MAIN

● Curb Box

RENEWAL TAP