

LABOR AND MATERIALS

Copper	} Connection	_____	\$ _____	
Lead				
Curb	} Cock Valve T. S. & V. }	_____ in.	\$ _____	
Service box		} Short 3½ x 4½ Long 4½ x 5½ Buff or Rdway }	_____	\$ _____
Old returned				
Ft. _____ in.	} Copper G. I. C. I. }		Pipe at _____	\$ _____
Nipples _____ in.		at _____	\$ _____	
Bushings _____ to _____ in.	at _____	\$ _____		
Red'g } Inc'g }	} Coupl'gs _____ to _____ in.	at _____	\$ _____	
Union _____ in.		at _____	\$ _____	
Meter _____ in.	at _____	\$ _____		
Lead Joints	at _____	\$ _____		
Compound Joints	at _____	\$ _____		
Maintenance Foreman	_____	\$ _____		
Hrs. Water Maint. Man—1	at _____	\$ _____		
Hrs. Water Maint. Man—2	at _____	\$ _____		
Hrs. Garage Foreman	at _____	\$ _____		
Hrs. Labor— _____	at _____	\$ _____		
Hrs. Compressor at _____	_____	\$ _____		
Compensation Ins. at \$ _____	per C. _____	\$ _____		
Trucking _____	_____	\$ _____		
Pav't Patch _____	_____	\$ _____		
_____	_____	\$ _____		
_____	_____	\$ _____		
_____	_____	\$ _____		
_____	_____	\$ _____		
O'head _____	_____	\$ _____		
_____	_____	\$ _____		

FOR


WILLIAM

St.
No. _____
Ave. No. 10½

Name of Owner _____

Labor and Mat'l. Report

Oct 25 1954

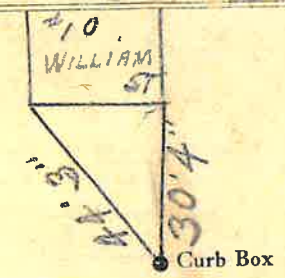

4" Main

Elev. of
Main at tap _____

Gate at • _____

• Gate at _____

TAX ID # 302.16-15-31

• Curb Box
*Measured from
#10 Williams*