

LABOR AND MATERIALS

1 Copper Lead Connection $\frac{3}{4}$ " \$

1 Curb } Cock Valve T.S. & V. } $\frac{3}{4}$ in. ORISEAL

1 Service box } Short $3\frac{1}{2} \times 4\frac{1}{2}$ }
 Old returned } Long $4\frac{1}{2} \times 5\frac{1}{2}$ }
 Buff or Rdway } \$

21 Ft. $\frac{3}{4}$ in. } Copper } Pipe at \$
 } G.I. }
 } G.I. }

Nipples in. at \$

Bushings to in. at \$

Red'g }
 Inc'g } Coupl'gs to in. at \$

Union in. at \$

Meter in. at \$

Lead Joints at \$

Compound Joints at \$

Maintenance Foreman \$

Hrs. Water Maint. Man-1 at \$

Hrs. Water Maint. Man-2 at \$

Hrs. Garage Foreman at \$

Hrs. Labor- at \$

Hrs. Compressor at \$

Compensation Ins. at \$ per C \$

Trucking \$

Pav't Patch \$


TAP MADE BY PECK & CO. \$

O'head NOV-16-1971 \$

WILLIAMS St. Pt. Ave. No. 11

Name of Owner EARL McQUAIN

Labor and Mat'l. Report NOV 16 1971

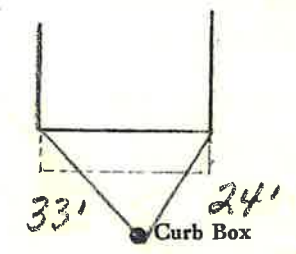

4" Main Elev. of Main at tap 5'

Gate at • Gate at

21' to main

• Curb Box

TAX ID# 302.16-17-21