

LABOR AND MATERIALS

| | | | | | |
|------|-------------------------------|----------------------|---------|----|-------|
| 1 | Copper Lead | Connection | 3/4" | \$ | 2.41 |
| 1 | Curb | Cock Valve T-S. & V. | 3/4 in. | \$ | 3.41 |
| Same | Service box | Short 3 1/2 x 4 1/2 | | \$ | |
| | Old returned | Long 4 1/2 x 5 1/2 | | \$ | |
| | | Buff or Rdway | | \$ | |
| 12 | Ft. 3/4 in. | Copper Pipe at | 40 | \$ | 480 |
| | | G.I. | | \$ | |
| | | C.I. | | \$ | |
| | Nipples | in. at | | \$ | |
| | Bushings | to in. at | | \$ | |
| | Red'g Inc'g | Coupl'gs to in. at | | \$ | |
| | Union | in. at | | \$ | |
| | Meter | in. at | | \$ | |
| | Lead Joints | at | | \$ | |
| | Compound Joints | at | | \$ | |
| | Maintenance Foreman | | | \$ | |
| | Hrs. Water Maint. Man-1 | at | | \$ | |
| 12 | Hrs. Water Maint. Man-2 | at 1.24 | | \$ | 14.88 |
| | Hrs. Garage Foreman | at | | \$ | |
| 13 | Hrs. Labor | at 1.13 | | \$ | 14.69 |
| | Hrs. Compressor | at | | \$ | |
| | Compensation Ins. at \$ 3.861 | per C. | | \$ | 1.14 |
| | Trucking | | | \$ | 1.50 |
| | Pav't Patch | | | \$ | 11.20 |
| | Tap made 4-20-54 | | | \$ | |
| | by Gist & Wadleigh | | | \$ | |
| | O'head | | | \$ | |
| | | | | \$ | 54.03 |

42.83

16-54

St. Pt. Ave. No. 12

William


Name of Owner

Walner

Labor and Mat'l. Report

April 20

1954

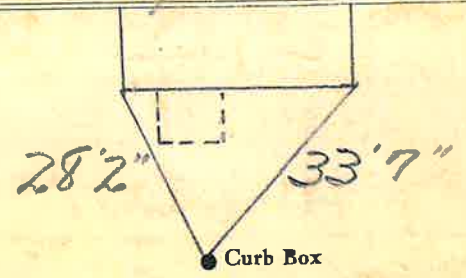

4" Main

Elev. of Main at tap 5 1/2'

Gate at •

• Gate at

12' to MAIN

• Curb Box

TAX ID# 302.16-15-32