

LABOR AND MATERIALS

Copper	} Connection		\$		
Lead					
Curb	} Cock Valve T. S. & V.	} in.	\$		
Service box Old returned	} Short 3½ x 4½ Long 4½ x 5½ Buff or Rdway	}	\$		
25 Ft. ¾ in.	} Copper G.I. C.I.	} Pipe at	\$		
Nipples	in. at		\$		
Bushings	to in. at		\$		
Red'g Inc'g	} Coupl'gs	to in. at	\$		
Union	in. at		\$		
Meter	in. at		\$		
Lead Joints	at		\$		
Compound Joints	at		\$		
Maintenance Foreman			\$		
Hrs. Water Maint. Man	1 at		\$		
Hrs. Water Maint. Man	2 at		\$		
Hrs. Garage Foreman	at		\$		
Hrs. Labor	at		\$		
Hrs. Compressor	at		\$		
Compensation Ins.	at \$ per C		\$		
Trucking			\$		
Pav't Patch			\$		
			\$		
			\$		
			\$		
O'head			\$		

St.
Pl.
Ave. No. 13


William

Name of Owner

Randall Lockhart

Labor and Mat'l. Report

19

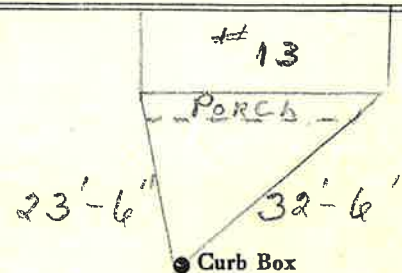

TAX ID # 302.16-17-20

Elev. of

Main

Main at tap

Gate at ●

● Gate at

25' to MAIN

● Curb Box