


Labor and Materials

.....Copper	} Connection.....	3	.	96
.....				
.....Curb	{ Cock Valve T.S.&V. }	3	.	1.30
.....				
.....Service Box	{ Short 2 1/2 x 4 1/2 Long 4 1/2 x 6 1/2 } Old returned	4	.	1.35
.....				
.....12 Ft. ^{3/4} in.	{ Copper Galv. Iron Cast Iron }	15	.	1.80
.....Nipplesin. at		.	
.....Bushingstoin. at		.	
.....Red'g Inc'g	} Couplings.....to.....in.at		.	
.....				
.....Unionin. at		.	
.....Meterin. at		.	
.....Lbs. Br. Stone	at		.	
.....Lbs. Sand	at		.	
.....Bags Cement	at		.	
.....Paving Brick	{ Mack Red Asphalt }	at	.	
.....Lead Joints		at	.	
.....Leadite Joints	at	.		
.....Hrs. Foreman	at	.		
.....Hrs. Common Labor	at	.		
.....Hrs. Common Labor	at	.		
.....Hrs. Mason	at	.		
.....Hrs. Masons Helper	at	.		
.....Hrs. Compressor	at	.		
.....Compensation Ins		.		
.....Trucking		.		
.....Builders Use of Water	Watch	5	.	
Total \$				

30136
 Labor and Material Report *May 22* 1936

16 *Wilmot St*

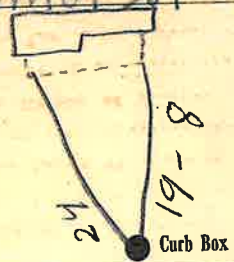

6 Main Elev. of Main at tap 5
 Gate at • Gate at •
 12' to main
 • Curb Box

Old tap disconnected
 TAX ID #309.7-9-18

[Signature]