


LABOR AND MATERIALS

1 Copper } Connection  $\frac{3}{4}$ " \$  
 -Lead }  
 1 Curb } Cock }  $\frac{3}{4}$  Oriseal \$  
           } Valve }  
           } T.S. & V. }  
 1 Service box { Short  $3\frac{1}{2}$  x  $4\frac{1}{2}$  }  
 Old returned { Long  $4\frac{1}{2}$  x  $5\frac{1}{2}$  }  
                   } Buff or Rdway } \$  
 11 Ft.  $\frac{3}{4}$  in. { Copper } Pipe at \$  
                   } C.I. }  
                   } C.I. }  
 Nipples in. at \$  
 Bushings to in. at \$  
 Red'g }  
 Inc'g } Coupl'gs to in. at \$  
 Union in. at \$  
 Meter in. at \$  
 Lead Joints at \$  
 Compound Joints at \$  
 Maintenance Foreman \$  
 Hrs. Water Maint. Man-1 at \$  
 Hrs. Water Maint. Man-2 at \$  
 Hrs. Garage Foreman at \$  
 Hrs. Labor at \$  
 Hrs. Compressor at \$  
 Compensation Ins. at \$ per C \$  
 Trucking \$  
 Pav't Patch \$  
 Tap by G. L. GORDON & CO \$  
           11-14-63. \$  
 O'head \$  
 \$

Wilmot St. Pl. Ave. No. 18  
 Name of Owner Robert Lalor

Labor and Mat'l. Report 19

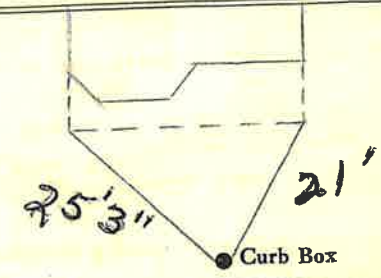

6" C.I. Main Elev. of Main at tap  $4\frac{1}{2}'$

Gate at • Gate at  
 11' to MAIN

• Curb Box

TAX ID # 309.79-19