

19

LABOR AND MATERIALS

1	Copper	Connection	3/4	\$	2.87
1	Lead				
1	Curb	Cock Valve T. S. & V.	3/4 in.	\$	3.62
1	Service box	Short 3 1/2 X 4 1/2			
	Old returned	Long 4 1/2 X 5 1/2			
		Buffer Rdway		\$	4.68
19	Ft.	3/4 in.	Copper Pipe at	32	\$ 6.08
			G.I.		
			C.I.		
	Nipples	in. at		\$	
	Bushings	to in. at		\$	
	Red'g			\$	
	Inc'g	Coupl'gs to in. at		\$	
	Union	in. at		\$	
	Meter	in. at		\$	
	Lead Joints	at		\$	
	Compound Joints	at		\$	
6	Hrs. Water Maint. Man-1	at		\$	
6	Hrs. Water Maint. Man-2	at 1.02		\$	6.12
2.4	Hrs. Labor-	at 91		\$	21.84
	Hrs. Labor-	at		\$	
2	Hrs. Compressor at	1.20		\$	2.40
	Compensation Ins. at \$ 2.18 per C.			\$	6.1
	Trucking			\$	2.00
	Pav't Patch			\$	18.25
	Tap by MARS installed			\$	
	O'head			\$	
				\$	60.47

20

 St.
 Pl.
 Ave. No. 19

Wilmot


Name of Owner

Taylor

Labor and Mat'l. Report

Apr 26

1949

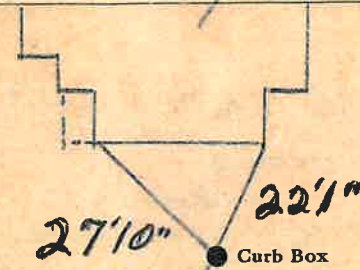

6 Main

Elev. of
Main at tap 5-

Gate at ●

● Gate at

19' to main

● Curb Box

TAX ID # 309.7-8-1