

LABOR AND MATERIALS

1/	Copper	Connection	3/4	\$ 2.94
1/	Lead	Cock	3/4	
1/	Curb	Valve	3/4 in.	\$ 3.71
		T. S. & V.		
.....	Service box	Short 3 1/2 X 4 1/2	} Same	\$ —
.....	Old returned	Long 4 1/2 X 5 1/2		
		Buff or Rdway		
11 Ft.	3/4 in.	Copper	Pipe at 30	\$ 3.30
		G. I.		
		C. I.		
.....	Nipples	in. at		\$
.....	Bushings	to in. at		\$
.....	Red'g			
.....	Inc'g	Coupl'gs to in. at		\$
.....	Union	in. at		\$
.....	Meter	in. at		\$
.....	Lead Joints	at		\$
.....	Compound Joints	at		\$
.....	Hrs. Water Maint. Man	—1 at		\$
9	Hrs. Water Maint. Man	—2 at 1.02		\$ 8.16
12	Hrs. Labor	at 91		\$ 10.92
.....	Hrs. Labor	at		\$
1	Hrs. Compressor	at		\$ 1.20
.....	Compensation Ins.	at \$ per C		\$ 42
.....	Trucking			\$ 1.30
.....	Pav't Patch			\$ 5.30
.....	T. S. & V.			\$
.....	O'head			\$
				\$ 36.94

141


St. _____
 Pt. _____
 Ave. No. 22

W. Trout

Name of Owner

Little

Labor and Mat'l. Report Oct 7 1948

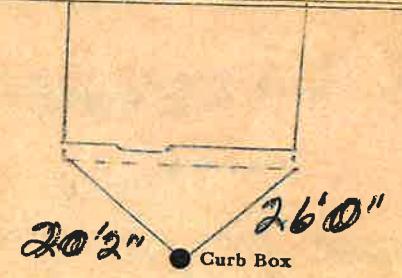

6 Main Elev. of Main at tap 6

Gate at ● Gate at ●

11' to main

● Curb Box

TAX ID# 309.79-21