


LABOR AND MATERIALS

Copper	} Connection _____	\$ _____	
Lead			
Curb	} _____ in. _____	\$ _____	
			Cock
			Valve
	T. S. & V. }		
Service box	} Short 3½ x 4½ }	\$ _____	
Old returned			Long 4½ x 5½ }
18 Ft. ¾ in.	} Copper G.I. G.I. }	Pipe at _____ \$ _____	
Nipples	in. at _____	\$ _____	
Bushings	to _____ in. at _____	\$ _____	
Red'g }	} Coupl'gs _____ to _____ in. at _____	\$ _____	
Inc'g }			
Union	in. at _____	\$ _____	
Meter	in. at _____	\$ _____	
		\$ _____	
Compound Joints	at _____	\$ _____	
Maintenance Foreman		\$ _____	
Hrs. Water Maint. Man-1	at _____	\$ _____	
Hrs. Water Maint. Man-2	at _____	\$ _____	
Hrs. Garage Foreman	at _____	\$ _____	
Hrs. Labor	at _____	\$ _____	
Hrs. Compressor	at _____	\$ _____	
		\$ _____	
Trucking		\$ _____	
Pav't Patch		\$ _____	
		\$ _____	
		\$ _____	
		\$ _____	
		\$ _____	

St. WILMOT ~~Pl.~~ Ave. No. 3
 Name of Owner _____
 TAX ID # 309.7-8-9

Labor and Mat'l. Report _____ 1991

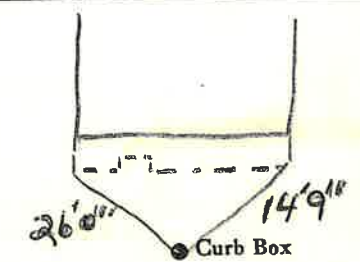

Main _____ Elev. of Main at tap _____
 Gate at • _____ Gate at _____
18' to MAIN
 • Curb Box

RENEWAL TAP - AUG 191