


Labor and Materials

Lead Connection <i>3</i>	\$
Curb Cock	\$
Service Box (Short 31 x 41)	\$
Old returned (Buffalo)	\$
Ft. in. <i>Copper 3/4</i> Pipe at	\$
Nipples..... in. at	\$
Bushings..... to..... in. at	\$
Red'g Coup..... to..... in. at	\$
Inc'g Coup..... to..... in. at	\$
Union..... in. at	\$
Meter..... in. at	\$
Cu. Yds. Br. Stone at	\$
Cu. Yds. Sand at	\$
Bags Cement at	\$
Paving Brick { Mack Red Asphalt } at	\$
Hrs. Foreman at	\$
Hrs. Common Labor at	\$
Hrs. Mason at	\$
Hrs. at	\$
Hrs. at	\$
Hrs. at	\$
Hrs. at	\$
Builders' Use of Water	\$
..... at	\$
..... at	\$
Total	\$ 13.72	

Labor and Material Report

19 *35*

4 *Richmond St.*

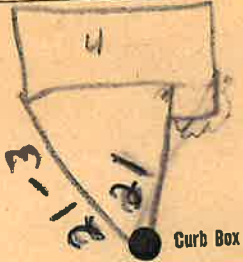

Elev. of Main at tap *4 1/2*

Gate at *6* Main

TAX ID # *309.7-9-13*

Curb Box *11' to main*
Old type disconnected

1-10-93

NEW SERVICE *W* + CO *3/4\"/>*