

LABOR AND MATERIALS

1 Copper Lead } Connection <sup>3/4"</sup> \$

1 Curb { Cock Valve } <sup>3/4</sup> in. \$

1 Service Box { Short 3 1/2 x 4 1/2 } \$

Old returned { Long 4 1/2 x 5 1/2 } \$

14 Ft. <sup>3/4</sup> in. { Copper Galv Iron Cast Iron } Pipe at \$

Nipples in. at \$

Bushings to in. at \$

Red'g Inc'g } Couplings to in. at \$

Union in. at \$

Meter in. at \$

Lead Joints at \$

Leadite Joints at \$

Hrs. Foreman at \$

Hrs. Chauffeur at \$

Hrs. Tapper at \$

Hrs. Labor at \$

Hrs. Labor at \$

Hrs. Compressor at \$

Compensation Ins. \$

Trucking \$

Builders Use of Water \$

Tap by Gifford & Co. 10-7-58 \$

\$

\$

\$


St. Wilmot

Pl. 6

Ave. No. 6

Name of Owner Damiano Bisignano

Labor and Mat'l. Report Oct. 7 1958

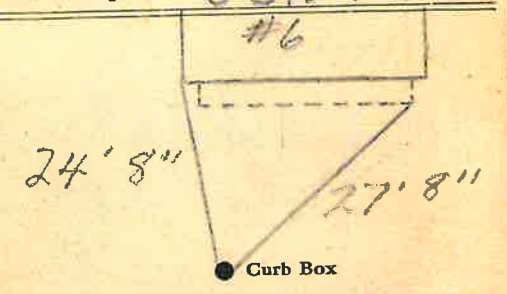

6" Main Elev. of Main at tap 5'

Gate at ● Gate at ●

14' to MAIN

● Curb Box

TAX ID# 309.7-9-14