

LABOR AND MATERIALS


1	Copper Lead	} Connection	3/4		\$ 1.35	
1	Curb	{ Cock Valve F. S. & V.	{ 3/4	in.	\$ 1.80	
1	Service Box Old returned	{ Short 3 1/4 x 4 1/4 Long 4 1/4 x 5 1/4 Buff for Rdway	{		\$ 1.70	
17	Ft.	3/4	in.	{ Copper Galv Iron Cast Iron	Pipe at 18 \$ 3.06	
	Nipples		in.	at	\$	
	Bushings		to	in.	at \$	
	Red'g Inc'g	{ Couplings		to	in.	at \$
	Union		in.	at	\$	
	Meter		in.	at	\$	
	Lead Joints		at		\$	
	Leadite Joints		at		\$	
	Hrs. Foreman				\$	
4	Hrs. Chauffeur		6 1/2		\$ 2.50	
6	Hrs. Tapper		1		\$ 3.75	
16	Hrs. Labor		45		\$ 7.20	
	Hrs. Labor				\$	
	Hrs. Compressor				\$	
	Compensation Ins.				\$.41	
	Trucking				\$	
	Builders Use of Water		Spateh		\$ 5.-	
	Tap by Hessel				\$	
					\$	
					\$	
					\$ 27.77	

4 0 1941

St. Wilimont
Pt.
Ave. No. 7

Name of Owner Howard Patten

Labor and Mat'l. Report JUNE 10 1941

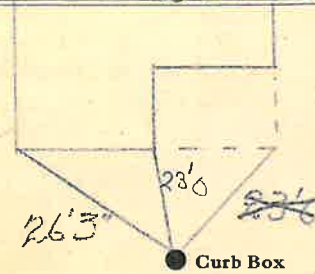

6 Main

Elev. of Main at tap 5-

Gate at ●

● Gate at

17' to MAIN

● Curb Box

TAX ID # 309.7-8-7