


Labor and Materials

1	Copper	Connection	\$ 2.60
1	Curb	Cock Valve T. S. & V. in.....	\$ 2.27
1	Service Box Old returned	Short 3/4x4 1/2 Long 4x6 1/2 Buff or Rdway	\$ 1.38
19	Ft.	Copper Galv. Iron Cast Iron in. at.....	\$ 3.42
	Nipples in. at.....	\$
1	Bushings to 1/2 in. at.....	\$.10
	Red'g Inc'g	Couplings to..... in. at.....	\$
	Union in. at.....	\$
	Meter in. at.....	\$
	Lbs. Br. Stone	at.....		\$
	Lbs. Sand	at.....		\$
	Bags Cement	at.....		\$
	Paving Brick	Mack Red Asphalt at.....	\$
	Lead Joints	at.....		\$
	Leadite Joints	at.....		\$
12	Hrs. Foreman	at.....		\$ 1.50
7	Hrs. Common Labor	at.....		\$ 3.15
	Hrs. Common Labor	at.....		\$
	Hrs. Mason	at.....		\$
	Hrs. Mason's Helper	at.....		\$
	Hrs. Compressor	at.....		\$
	Compensation Ins		\$.33
	Trucking		\$ 1.00
	Builders' Use of Water	Pitch	\$ 5.00
	Total			\$ 26.75

Labor and Material Report

5
11 Hillwood St

Mar 2 19 32

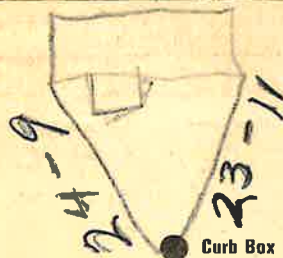

6 Main

Elev of Main at tap

4 1/2

Gate at ●

Gate at ●

19' to MAIN

● Curb Box

old pay sheet
at main

No application
made out

TAX ID # 309.7-8-5