

## LABOR AND MATERIALS

1	Copper Lead	Connection	3/4		\$ 2.87
1	Curb	Cock Valve T. S. & V.	3/4 in.		\$ 3.62
1	Service box	Short 3 1/2 X 4 1/2			
	Old returned	Long 4 1/2 X 5 1/2			
		Buffer Rdway			\$ 4.68
13	Ft. 3/4 in.	Copper G-F C.F.	Pipe at 32		\$ 4.16
	Nipples	in. at			\$
	Bushings	to in. at			\$
	Red'g Inc'g	Coupl'gs to in. at			\$
	Union	in. at			\$
	Meter	in. at			\$
	Lead Joints	at			\$
	Compound Joints	at			\$
	Hrs. Water Maint. Man-1	at			\$
13	Hrs. Water Maint. Man-2	at	1.02		\$ 13.26
1.0	Hrs. Labor-	at	91		\$ 9.10
	Hrs. Labor-	at			\$
1	Hrs. Compressor	at	1.20		\$ 1.20
	Compensation Ins. at \$	per C			\$ 1.49
	Trucking				\$ 2.00
	Pav't Patch				\$ 10.25
	Top 4. 1927				\$
	O'head				\$
					\$ 51.63

6

W. H. Mott


St. PL  
Ave. No. 12

Name of Owner

73 H. St.

Labor and Mat'l. Report

Dec 16 1948

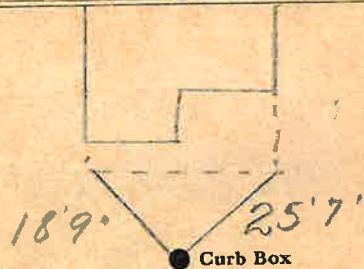

● Curb Box

6

Main

Elev. of Main at tap 5

Gate at ●

● Gate at

13' to MAIN

● Curb Box

TAX ID # 309.7-9-16