


LABOR AND MATERIALS

1	Copper	} Connection	3/4"	\$	
1	Lead				
1	Curb	} Cock Valve	3/4 in. or seal	\$	
					T.S. & V.
1	Service box	} Short 3 1/2 x 4 1/2		\$	
Old returned					Long 4 1/2 x 5 1/2
					Buff or Rdway
40	Ft. 3/4 in.	} Copper	Pipe at	\$	
					G.I.
					C.I.
	Nipples	in. at	\$		
	Bushings	to in. at	\$		
	Red'g	} Coupl'gs	to in. at	\$	
	Inc'g				
	Union	in. at	\$		
	Meter	in. at	\$		
	Lead Joints at		\$		
	Compound Joints at		\$		
	Maintenance Foreman		\$		
	Hrs. Water Maint. Man-1 at		\$		
	Hrs. Water Maint. Man-2 at		\$		
	Hrs. Garage Foreman at		\$		
	Hrs. Labor at		\$		
	Hrs. Compressor at		\$		
	Compensation Ins. at \$	per C	\$		
	Trucking		\$		
	Pav't Patch		\$		
	Tap by Gifford & Co.		\$		
	12 - 9 - 63		\$		
	O'head		\$		

Rd. Windy Hill
 St.
 Pl.
 Ave. No. 11
 Name of Owner John Wheeler
 TAX ID # 303.9-8-30

Labor and Mat'l. Report Dec. 9 1963

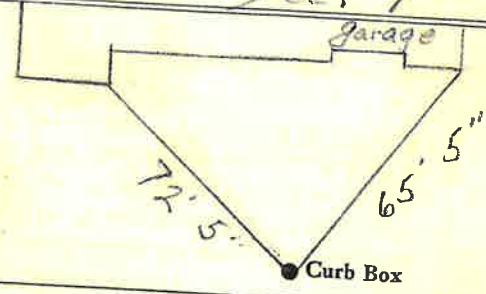

6" C.I. Main
 Elev. of Main at tap 4 1/2'
 Gate at ● Gate at ●
40' to main
 ● Curb Box