

LABOR AND MATERIALS


1	Copper	Connection	3/4"	\$
1	Lead	Cock	3/4"	\$
1	Curb	Valve	3/4"	\$
		T. S. & V.		
1	Service box	Short 3 1/2 x 4 1/2		
	Old returned	Long 4 1/2 x 5 1/2		
		Buff or Rdway		\$
66	Ft. 3/4 in.	Copper	Pipe at	\$
		G. I.		
		C. I.		
	Nipples	in. at		\$
	Bushings	to in. at		\$
1	Red'g	Coupl'gs 3/4 to 3/4 in.	at	\$
	Inc'g			
	Union	in. at		\$
	Meter	in. at		\$
	Lead Joints	at		\$
	Compound Joints	at		\$
	Maintenance Foreman			\$
	Hrs. Water Maint. Man-1	at		\$
	Hrs. Water Maint. Man-2	at		\$
	Hrs. Garage Foreman	at		\$
	Hrs. Labor	at		\$
	Hrs. Compressor	at		\$
	Compensation Ins. at \$	per C		\$
	Trucking			\$
	Pav't Patch			\$
	Tap by Gissord & Co.			\$
	6-24-63.			\$
	O'head			\$

Lot-15
St- 15
Pl- 14
Ave. No. 14

Windy Hill Rd.
Name of Owner J. Wheeler.

TAX ID # 303.9-8-29

Labo'r and Mat'l. Report June 24 1963

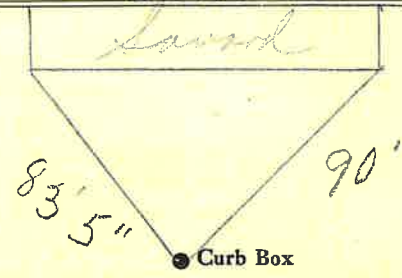

6" C.I. Main Elev. of Main at tap 5'

Gate at • Gate at

66' to main

• Curb Box