

LABOR AND MATERIALS

| | | | | |
|--------------|----------------------------|--------------------------------------|----|-------------------------------|
| 1 | Copper | } Connection ^{3/4"} | \$ | |
| 1 | Lead | | | |
| 1 | Curb | } ^{3/4} in. <i>Oriseal.</i> | \$ | |
| | Valve | | | |
| | | T.S. & V. | | |
| 1 | Service box | } ^{Short 3 1/2 x 4 1/2} | \$ | |
| 1 | Old returned | | | ^{Long 4 1/2 x 5 1/2} |
| | | | | ^{Buff or Rdway} |
| 12 | Ft. ^{3/4} in. | } Pipe at | \$ | |
| | | | | ^{Copper} |
| | | ^{G.I.} | | |
| | | ^{C.I.} | | |
| | Nipples | in. at | \$ | |
| | Bushings | to in. at | \$ | |
| | Red'g | } Coupl'gs to in. at | \$ | |
| | Inc'g | | | |
| | Union | in. at | \$ | |
| | Meter | in. at | \$ | |
| | Lead Joints at | | \$ | |
| | Compound Joints at | | \$ | |
| | Maintenance Foreman | | \$ | |
| | Hrs. Water Maint. Man—1 at | | \$ | |
| | Hrs. Water Maint. Man—2 at | | \$ | |
| | Hrs. Garage Foreman at | | \$ | |
| | Hrs. Labor at | | \$ | |
| | Hrs. Compressor at | | \$ | |
| | Compensation Ins. at \$ | per C | \$ | |
| | Trucking | | \$ | |
| | Pav't Patch | | \$ | |
| | <i>Tap by Gifford +</i> | | \$ | |
| | <i>Peter-son</i> | | \$ | |
| | <i>5-11-67.</i> | | \$ | |
| | O'head | | \$ | |
| | | | \$ | |


Rd
-St-
-Pt-
Ave. No. 16

Windy Hill

Name of Owner *John Wheeler,*

TAX ID# *303.9-7-7*

Labor and Mat'l. Report *May 11* 19*67*

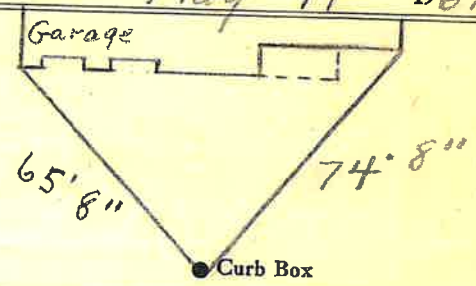

6" Main Elev. of Main at tap *6'*

Gate at ● ● Gate at

12' to main

● Curb Box