


Windy Hill ~~Rd~~
~~St~~
~~Pl~~
Ave. No. 17

Name of Owner John Wheeler,

Labor and Mat'l. Report Aug. 31 1966.

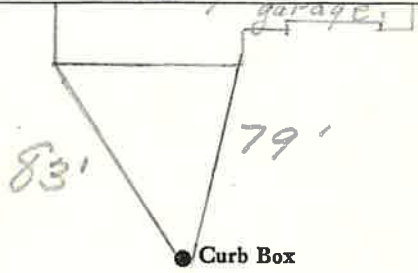

6" Main Elev. of Main at tap 5 1/2'

Gate at • Gate at •

24' to main


• Curb Box

Wendy Hill ~~Dn.~~
~~St.~~
~~Pl.~~
Ave. No. 17

Name of Owner

TAX ID# 303.9-8-28

Labor and Mat'l. Report 1971

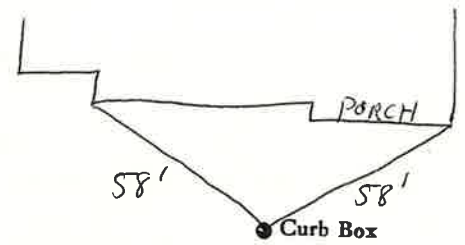

..... Main Elev. of Main at tap

Gate at • Gate at •

• Curb Box

LABOR AND MATERIALS

1	Copper	} Connection	$\frac{3}{4}$ "	_____	\$ _____
	Lead				
1	Curb	} Cock Valve T. S. & V.	$\frac{3}{4}$ in.	_____	\$ _____
1	Service box				
	Old returned				
		} Short $3\frac{1}{2}$ x $4\frac{1}{2}$ Long $4\frac{1}{2}$ x $5\frac{1}{2}$ Buff or Rdway	_____	\$ _____	
24	Ft. $\frac{3}{4}$ in.				
		} Copper G.I. C.I.	} Pipe at	_____	\$ _____
	Nipples _____ in. at				
	Bushings _____ to _____ in. at				
	Red'g } Inc'g } Coupl'gs _____ to _____ in. at	_____	\$ _____		
	Union _____ in. at				
	Meter _____ in. at	\$ _____			
	Lead Joints at	\$ _____			
	Compound Joints at	\$ _____			
	Maintenance Foreman	\$ _____			
	Hrs. Water Maint. Man—1 at	\$ _____			
	Hrs. Water Maint. Man—2 at	\$ _____			
	Hrs. Garage Foreman _____ at	\$ _____			
	Hrs. Labor _____ at	\$ _____			
	Hrs. Compressor at	\$ _____			
	Compensation Ins. at \$ _____ per C	\$ _____			
	Trucking	\$ _____			
	Pav't Patch	\$ _____			
	Tap by Gifford & Co.	\$ _____			
	8-31-66	\$ _____			
	O'head	\$ _____			
		\$ _____			
		\$ _____			

LABOR AND MATERIALS

	Copper	} Connection	_____	\$ _____	
	Lead				
	Curb	} Cock Valve T. S. & V.	_____ in.	\$ _____	
	Service box				
	Old returned				
		} Short $3\frac{1}{2}$ x $4\frac{1}{2}$ Long $4\frac{1}{2}$ x $5\frac{1}{2}$	_____	\$ _____	
	Ft. $\frac{3}{4}$ in.				
		} Copper G.I. C.I.	} Pipe at	_____	\$ _____
	Nipples _____ in. at				
	Bushings _____ to _____ in. at				
	Red'g } Inc'g } Coupl'gs _____ to _____ in. at	_____	\$ _____		
	Union _____ in. at				
	Meter _____ in. at	\$ _____			
	Compound Joints at	\$ _____			
	Maintenance Foreman	\$ _____			
	Hrs. Water Maint. Man—1 at	\$ _____			
	Hrs. Water Maint. Man—2 at	\$ _____			
	Hrs. Garage Foreman _____ at	\$ _____			
	Hrs. Labor _____ at	\$ _____			
	Hrs. Compressor at	\$ _____			
	Trucking	\$ _____			
	Pav't Patch	\$ _____			
		\$ _____			
		\$ _____			
		\$ _____			
		\$ _____			