


LABOR AND MATERIALS

1	Copper	Connection	3/4"	\$
1	Lead	Cock	3/4" O.I. seal	\$
1	Curb	Valve	3/4" in.	\$
		T.S. & V.		
1	Service box	Short 3 1/2 x 4 1/2		\$
	Old returned	Long 4 1/2 x 5 1/2		\$
		Buff. or Rdway		\$
37	Ft.	3/4" in. { Copper	Pipe at	\$
		{ G.I.		
		{ C.I.		
	Nipples	in. at	\$	
	Bushings	to in. at	\$	
	Red'g		\$	
	Inc'g	Coupl'gs to in. at	\$	
	Union	in. at	\$	
	Meter	in. at	\$	
	Lead Joints	at	\$	
	Compound Joints	at	\$	
	Maintenance Foreman		\$	
	Hrs. Water Maint. Man-1	at	\$	
	Hrs. Water Maint. Man-2	at	\$	
	Hrs. Garage Foreman	at	\$	
	Hrs. Labor	at	\$	
	Hrs. Compressor	at	\$	
	Compensation Ins. at \$	per C	\$	
	Trucking		\$	
	Pav't Patch		\$	
	Tap by		\$	
	O'head		\$	

Rd. Windy Hill
 St.
 Pl.
 Ave. No. 3

Name of Owner John Wheeler
 TAX ID# 303.9-8-35

Labor and Mat'l. Report Nov. 12 1965

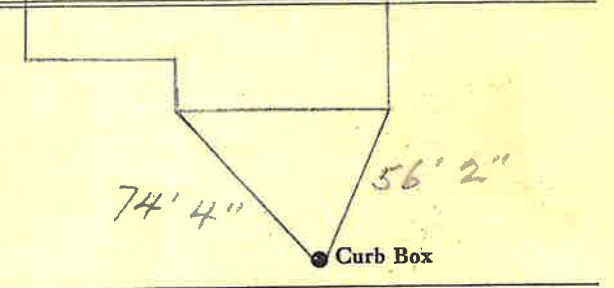

6" Main Elev. of Main at tap 5
 Gate at • Gate at
37' to main

• Curb Box