


LABOR AND MATERIALS

1	Copper	Connection	3/4"	\$
1	Curb	Cock Valve	3/4 in. <i>DRISER 1</i>	\$
1	Service box	Short 3 1/2 x 4 1/2		
	Old returned	Long 4 1/2 x 5 1/2		
		Buff. or Rdway		\$
11	3/4 in.	Copper	Pipe at	\$
		C.I.		
		C.I.		
	Nipples	in. at		\$
	Bushings	to in. at		\$
	Red'g			
	Inc'g	Coupl'gs to in. at		\$
	Union	in. at		\$
	Meter	in. at		\$
	Lead Joints at			\$
	Compound Joints at			\$
	Maintenance Foreman			\$
	Hrs. Water Maint. Man-1 at			\$
	Hrs. Water Maint. Man-2 at			\$
	Hrs. Garage Foreman at			\$
	Hrs. Labor at			\$
	Hrs. Compressor at			\$
	Compensation Ins. at \$	per C		\$
	Trucking			\$
	Pav't Patch			\$
	<i>TAP BY BEECHER &amp; CO</i>			\$
	<i>Sept. 4-1975</i>			\$
	O'head			\$

Windy Hill Rd. <sup>St.</sup> ~~St.~~ <sup>Ass.</sup> No. *22*

Name of Owner  
*Ernest Sullivan*

Labor and Mat'l. Report *Sept. 4 1975*

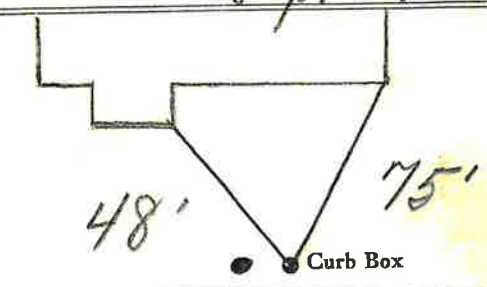

*8"* Main                      Elev. of Main at tap *5'*

Gate at •                      • Gate at

*11' to main*

• Curb Box

TAX ID # 303.9-7-10